

1 AS BUILT PLAN - GROUND FLOOR
A-101/ SC:1/50

EXISTING PICTURES



LEGEND:

NO INTERVENTION AREAS

ATTIC @ 2m

RAISED FLOOR

WOOD WALLS

GYPSUM BOARD WALLS

DOOR TAG
DW: wood door/door number
90x220:widthxheight

WINDOW TAG
WS: steel window/win. number
90x220:widthxheigh

CABINET TAG

FLOOR - ROOM NUMBER

CEILING
WALL
FLOOR
SKIRTING/HEIGHT

EXISTING AC SPLIT UNIT

NOTES:
-CONCRETE FLOOR HEIGHT 310 CM
-EXTERIOR DOORS ARE ALUMINUM.
-WINDOWS ARE ALUMINUM, WOOD OR STEEL.
-FALSE CEILING HEIGHT, 60x60:
. 270-275 CM FROM F.F.L

FINISHING SCHEDULE

 
C - CEILING
01: PLASTER + PAINT
02: PLASTER + GYP. BOARD CORNICE
03: PLASTER + GYP.BOARD
04: PLASTER + 60X60 CEILING

W - WALL
01: PLASTER + PAINT
02: CERAMIC
03: WOOD

F - FLOOR
01: MOSAIC TILES
02: CERAMIC TILES
03: WOOD RAISED FLOOR

S - SKIRTING
01: MOSAIC
02: CERAMIC
03: PARQUET

Key Plan



REV	BY	APP	DESCRIPTION	DATE

Revisions

NOTES:

- THIS DRAWING IS COPYRIGHTED AND IS NOT TO BE USED FOR ANY PURPOSE OTHER THEN FOR WHICH IT IS SUPPLIED.
- ALL DIMENSIONS ARE IN CENTIMETERS UNLESS OTHERWISE INDICATED. ALL LEVELS ARE IN METERS UNLESS OTHERWISE INDICATED.
- ALL WORKS SHALL BE CARRIED OUT IN ACCORDANCE WITH CURRENT SERVICES SEPARATIONS AND STANDARD DETAILS. THE CONTRACTORS SHALL COMPLY WITH ALL UTILITIES REQUIREMENTS AND PROVIDE ALL NECESSARY NOTICE AND ATTENDANCE TO THE CONCERNED AUTHORITIES PRIOR TO COMMENCEMENT OF ANY WORK ON THE SITE.
- THE DRAWINGS SHOULD BE READ IN CONJUNCTION WITH OTHER RELEVANT ARCHITECTURAL, STRUCTURAL, MECHANICAL, ELECTRICAL AND CIVIL DRAWINGS AND ALL RELEVANT SECTIONS OF THE SPECIFICATIONS.
- BEFORE STARTING ANY WORK, THE CONTRACTOR HAS TO SUBMIT SHOP DRAWINGS SHOWING ALL DETAILS NEEDED. THE ENGINEER APPROVAL OF THE SHOP DRAWING MUST BE OBTAINED PRIOR TO COMMENCEMENT OF WORK.
- DO NOT SCALE DRAWINGS, USE FIGURED DIMENSIONS ONLY.
- REPORT ANY DISCREPANCIES IMMEDIATELY TO THE ENGINEER.

THIS DRAWING IS A COPYRIGHT. DO NOT SCALE FROM THE DRAWING. THE CONTRACTOR AND HIS SUB-CONTRACTORS ARE TO VERIFY ALL DIMENSIONS ON SITE BEFORE MAKING SHOP DRAWINGS OR COMMENCING MANUFACTURE.



AGENCE FRANCAISE D'EXPERTISE
TECHNIQUE INTERNATIONALE
MHM Center- Peres Street - Adliye Beirut, Lebanon

PROGRAMME - PROJECT NAME:

Supporting progress in key areas of public administration reform in Lebanon.

CONSULTANT:

ARCHITECT MANALE BASSIL
JBEIL, Lebanon

PROJECT:

PUBLIC PROCUREMENT AUTHORITY (PPA)

PLOT NO.:

BLOCK:

Sheet Information

PROJECT NBR.	-
PROJECT PHASE	TENDER
DISCIPLINE	ARCHITECTURAL
SECTOR	-
BUILDING	-
DESIGNED	MB
DRAWN	MB
CHECKED	-
APPROVED	-
DATE	15.05.2026
SCALE	1/50
SHEET SIZE	A0

Sheet Title

GROUND FLOOR PLAN LAYOUT

AS BUILT PLAN LAYOUT

Sheet nbr.

T - A - 101 - R00

Phase	Discipline	Floor Area	Drawing Number	Revision
-------	------------	------------	----------------	----------